
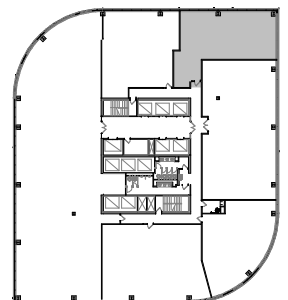


100 TOWER

Minneapolis, Minnesota

SUITE 1250 - SUITE AS-BUILT PLAN

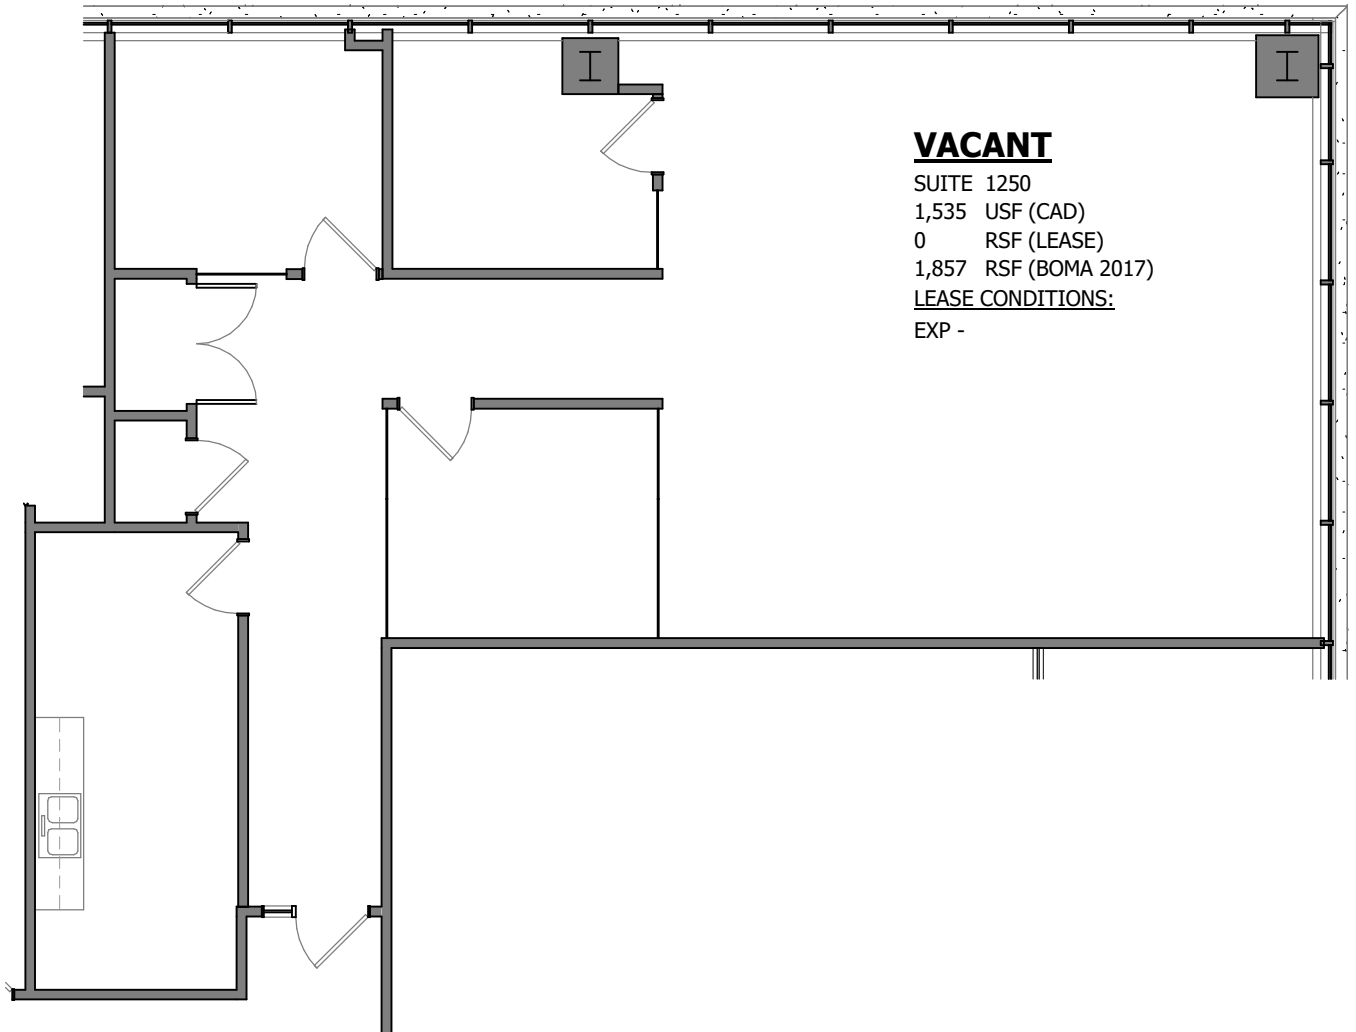

Zeller Realty Group®

NELSON

Issue Date: 06/22/2021