


Key Plan



NELSON One Premier Plaza • Suite 605 • 1,550 RSF

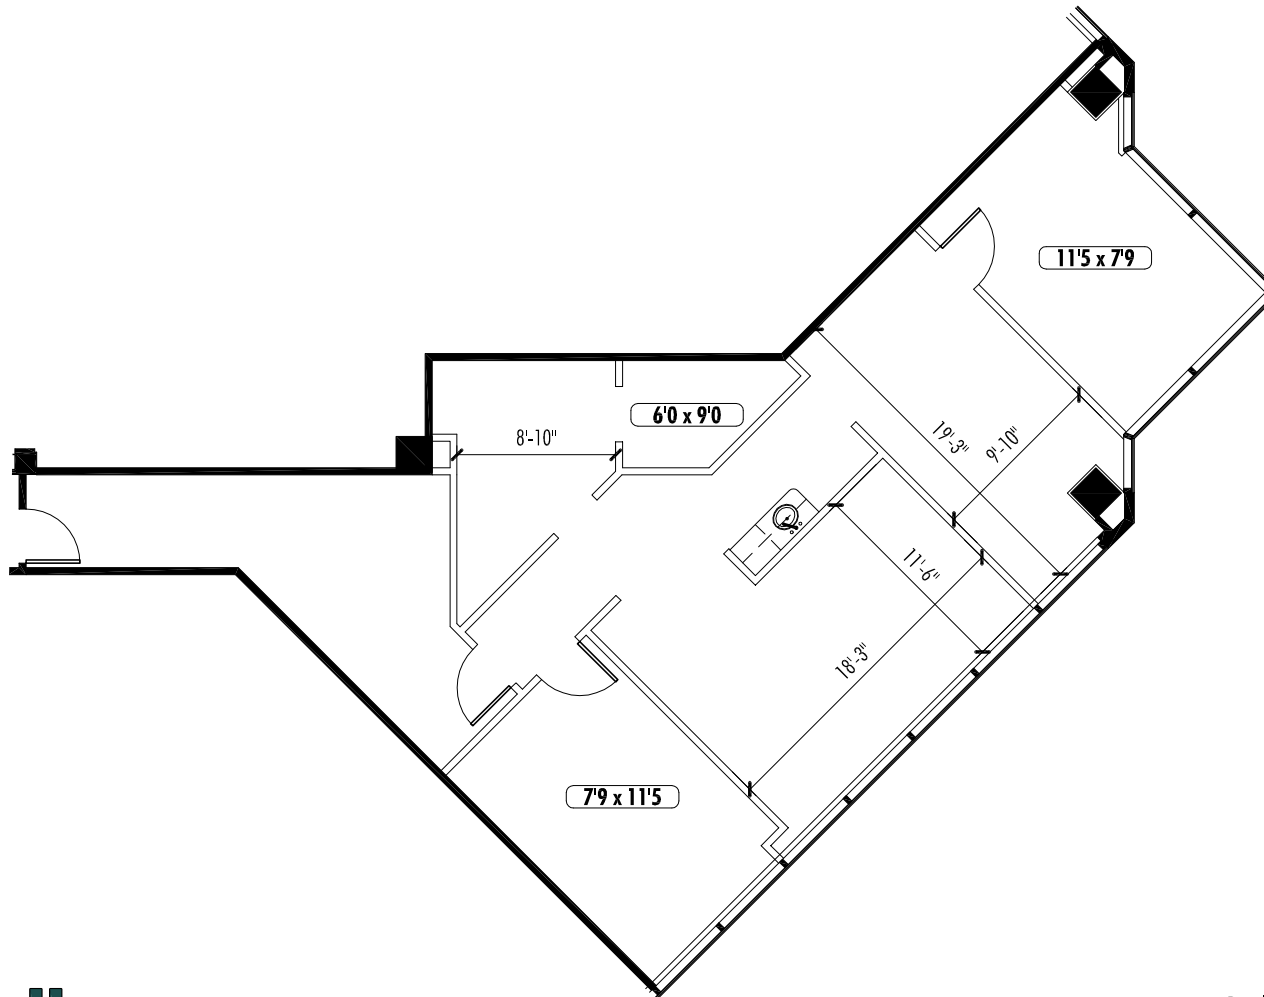

Brooke Dewey 404.995.2138
brooke.dewey@am.jll.com

David Horne 404.995.6321
david.horne@am.jll.com

As-Built